




**6 ELEVATOR #2 SECTION**  
 SCALE: 1/2" = 1'-0"

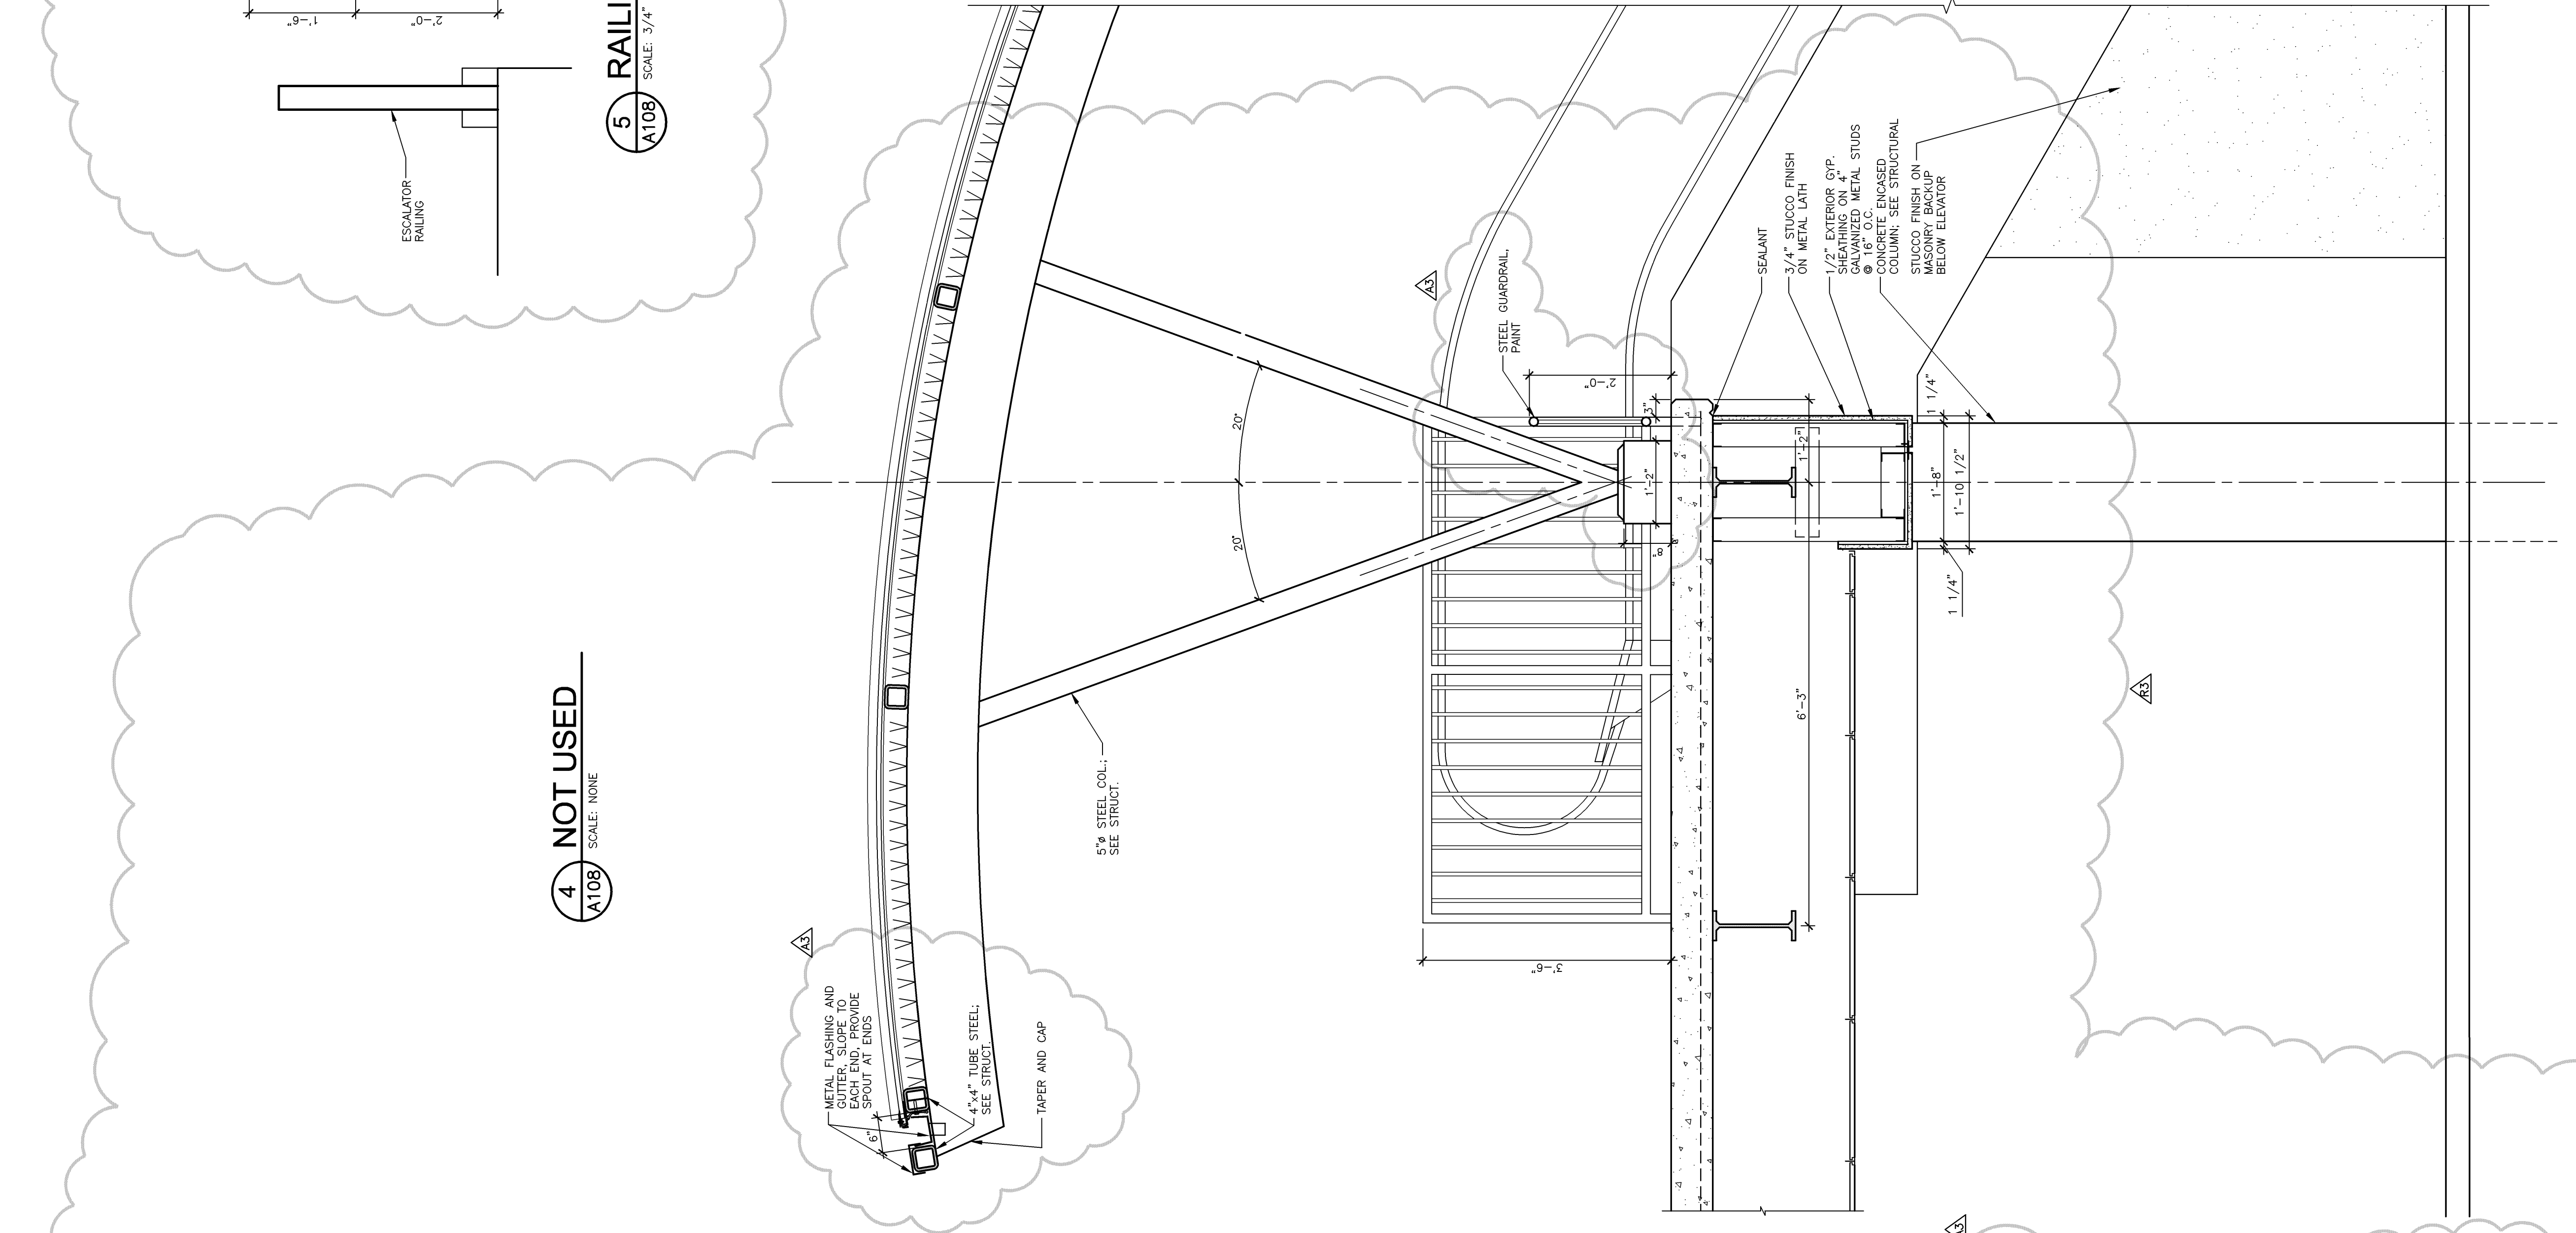


**3 ELEVATOR SECTION**  
 SCALE: 3/4" = 1'-0"

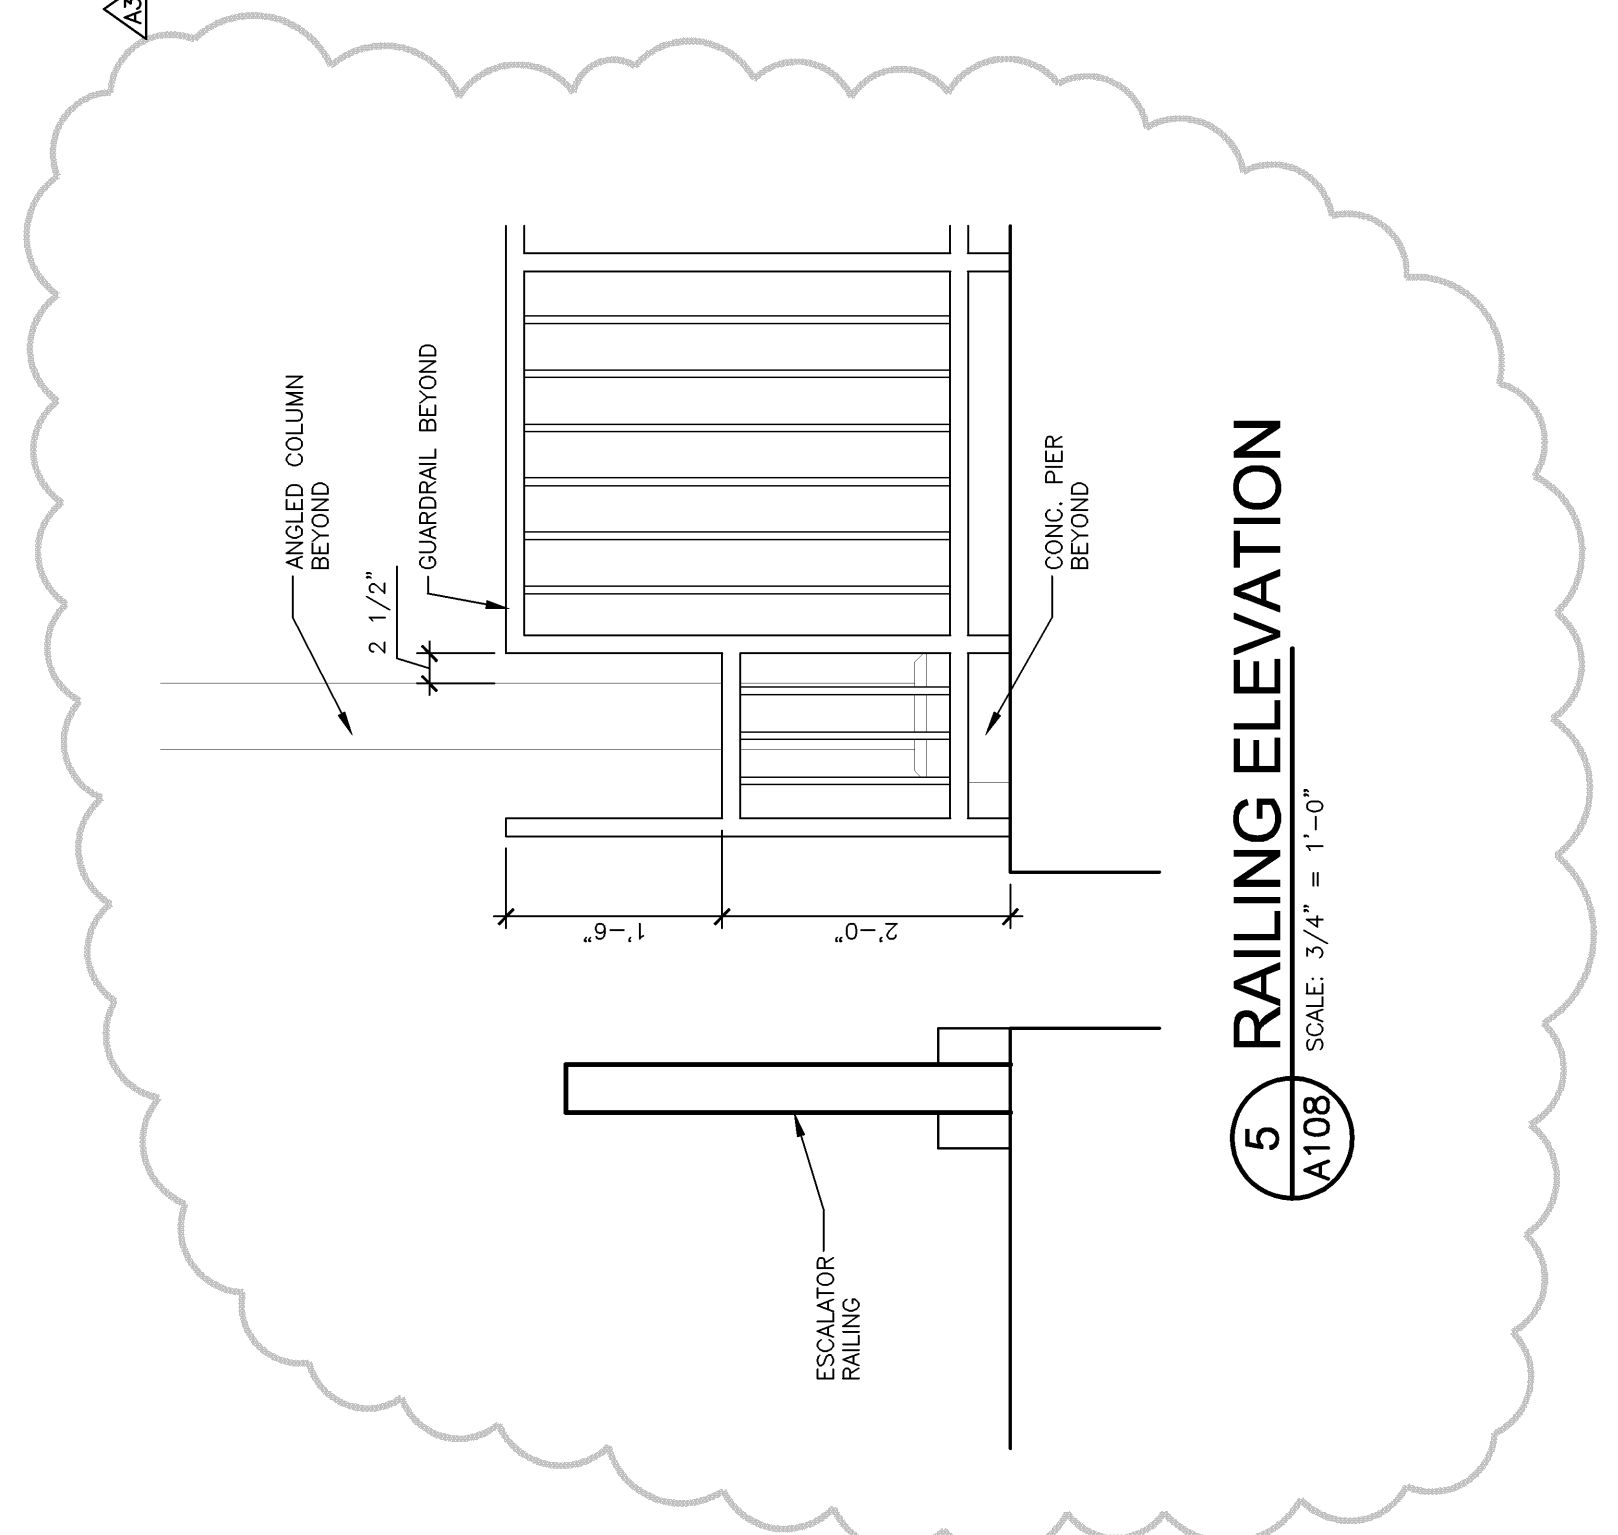

**5 RAILING ELEVATION**  
 SCALE: 3/4" = 1'-0"

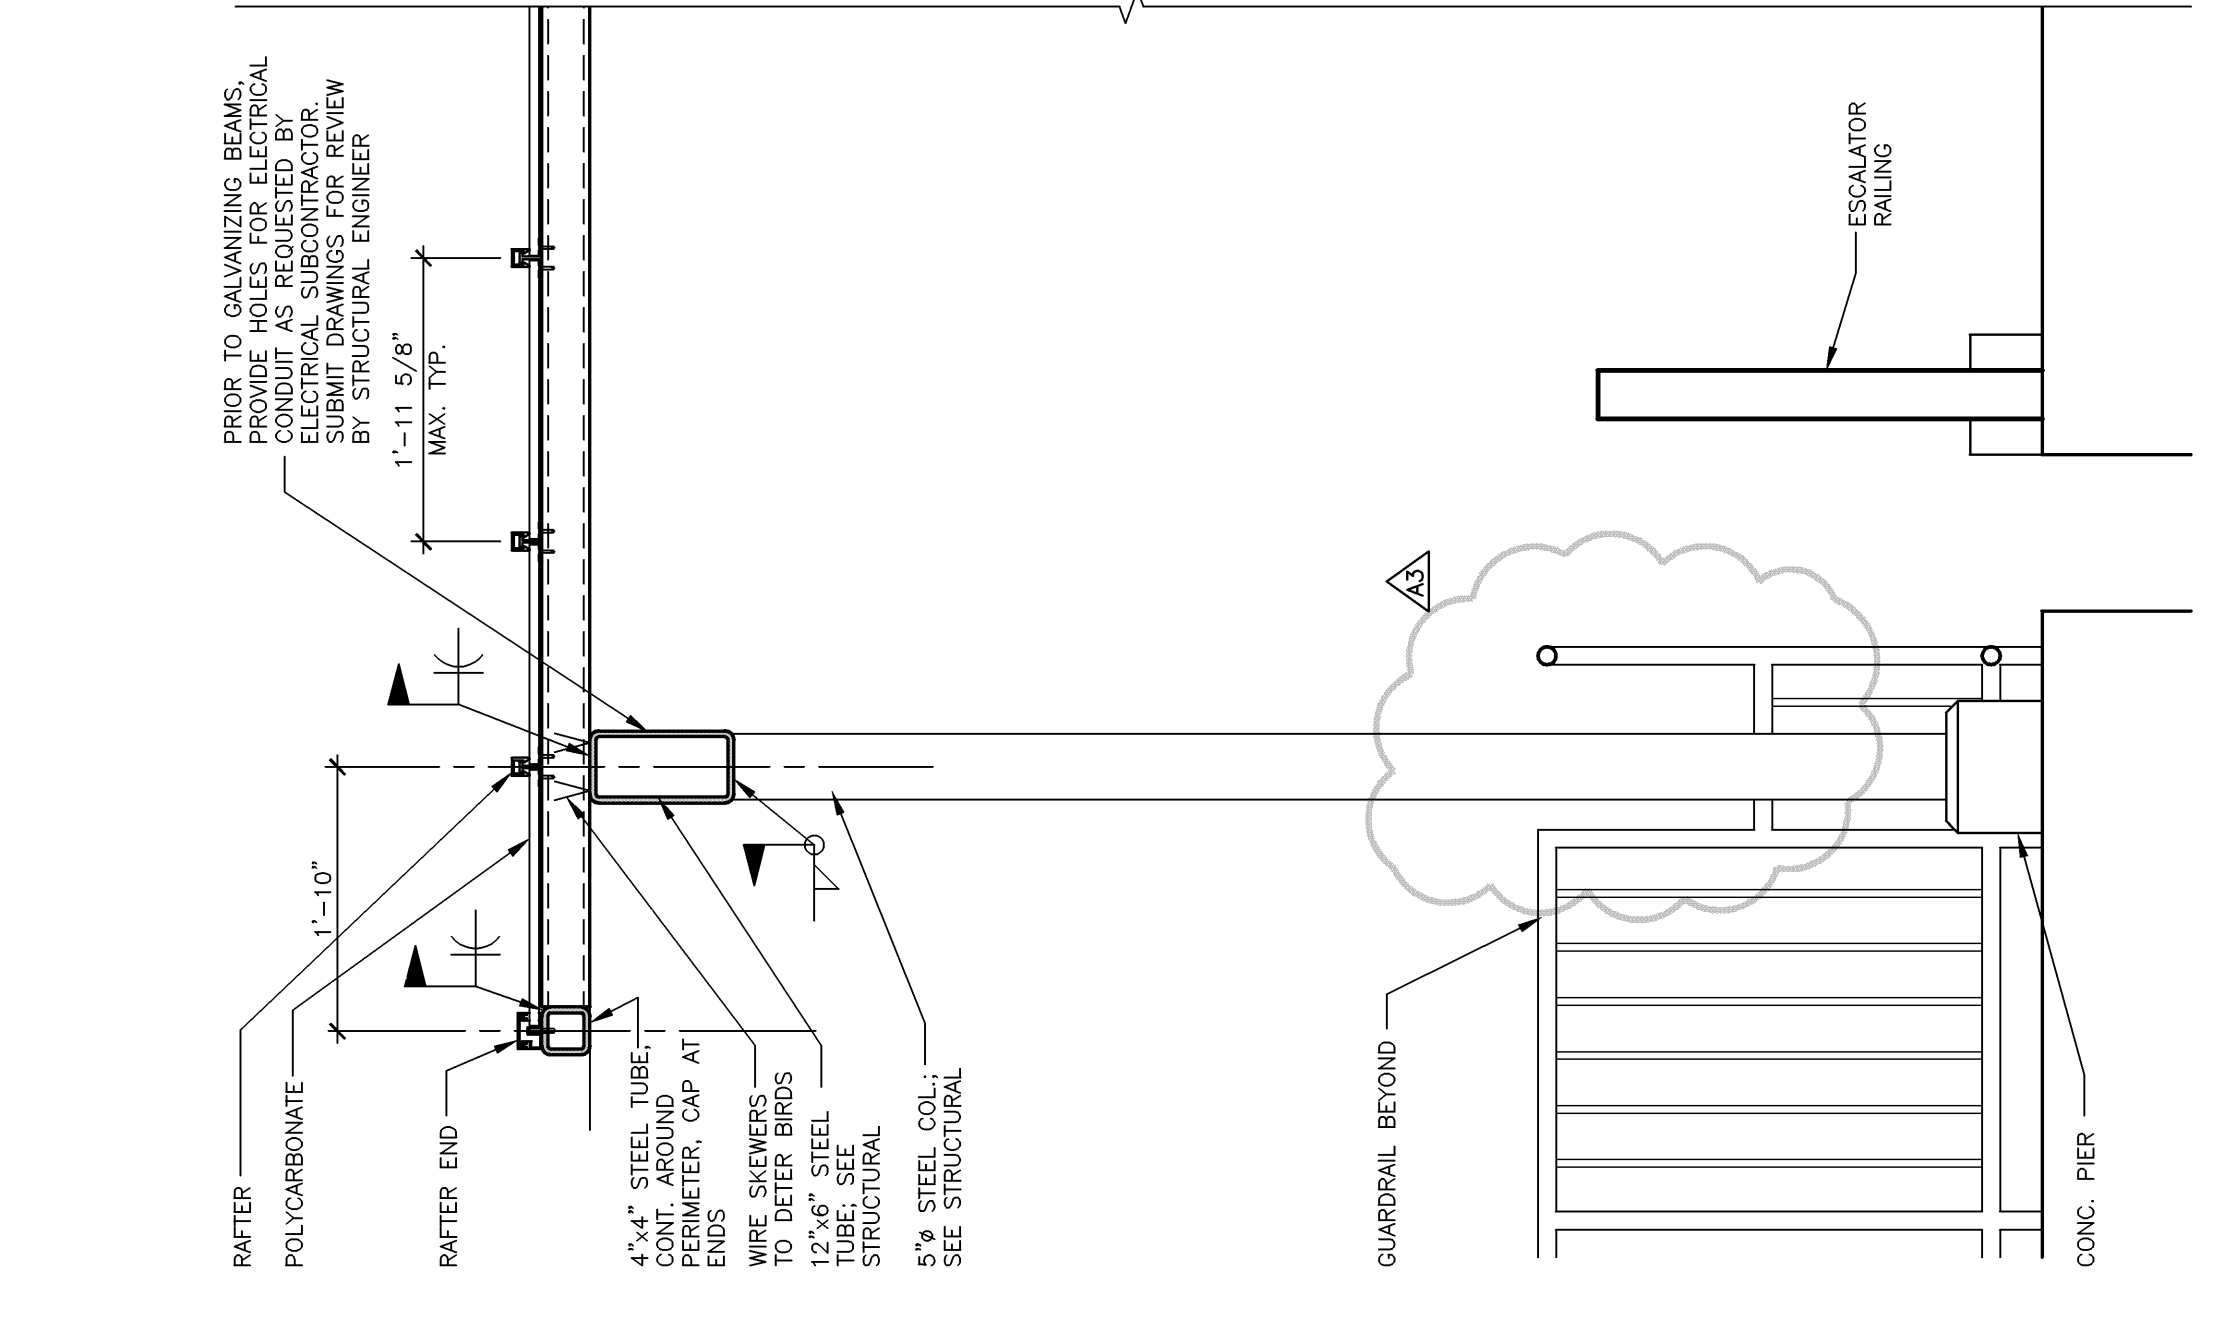

**1 ESCALATOR ROOF DETAIL**  
 SCALE: 3/4" = 1'-0"

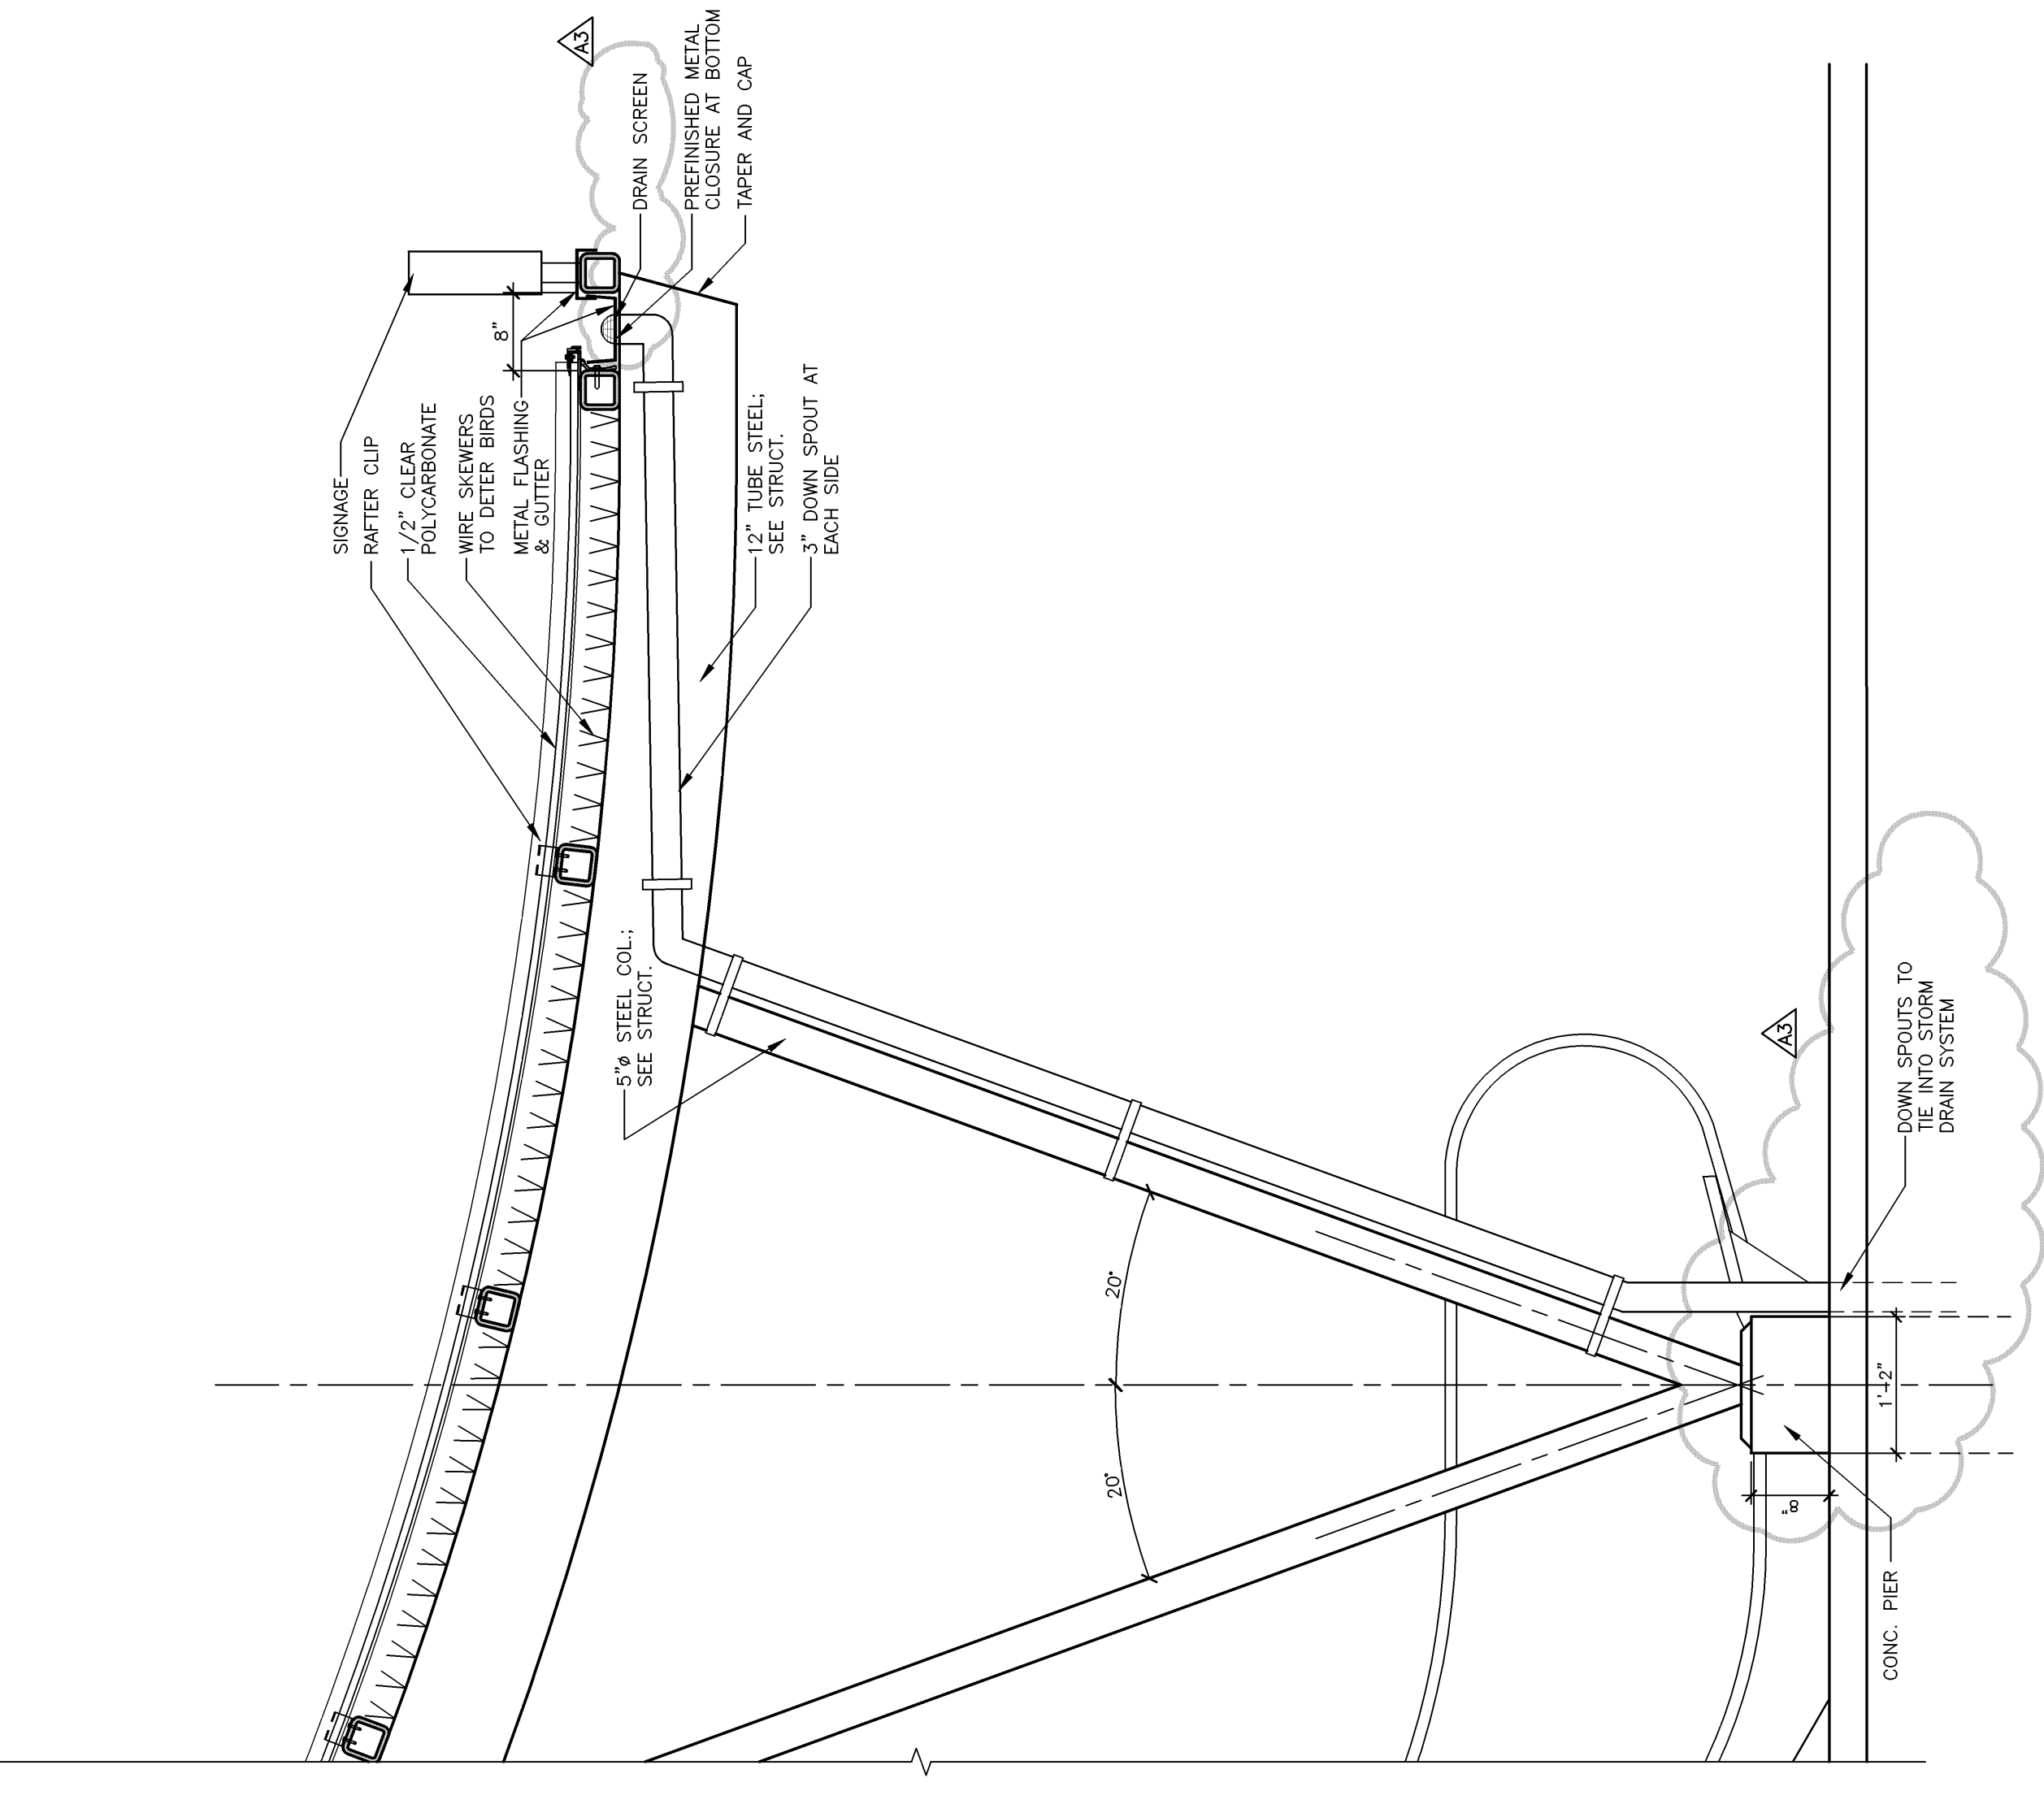

**2 ESCALATOR SECTION**  
 SCALE: 3/4" = 1'-0"

Drawn By	CEG
Checked	CEG
Design	CEG
Manager	DSS
ISSUED FOR PERMITS	9/14/2004
ISSUED FOR ADJUNCT NO. 3	4/6/2004
ISSUED FOR OWNER REVIEW & PRICING	3/25/2004
Hard copy is intended to be "As-Built" when plotted.	
Scale(s) indicated are not accurate for any other size.	

**FTGH**  
 Engineers • Scientists • Architects  
 Grand Rapids, Michigan (616) 755-8224  
 © Copyright 2005 All Rights Reserved

**LYNWOOD**  
 ALDERWOOD MALL  
 LOEWS THEATRES  
 WASHINGTON

PROJECT NO. **G022818C**  
 SHEET NO. **A515**